

Project Name

32 CENTER HILL ROAD
MONROE NY 10950
SBL 5-2-1

No.	Description	Date

Project number

Date

Drawn by


Reviewed By

DS

A - 1

Scale

3/8" = 1'-0"

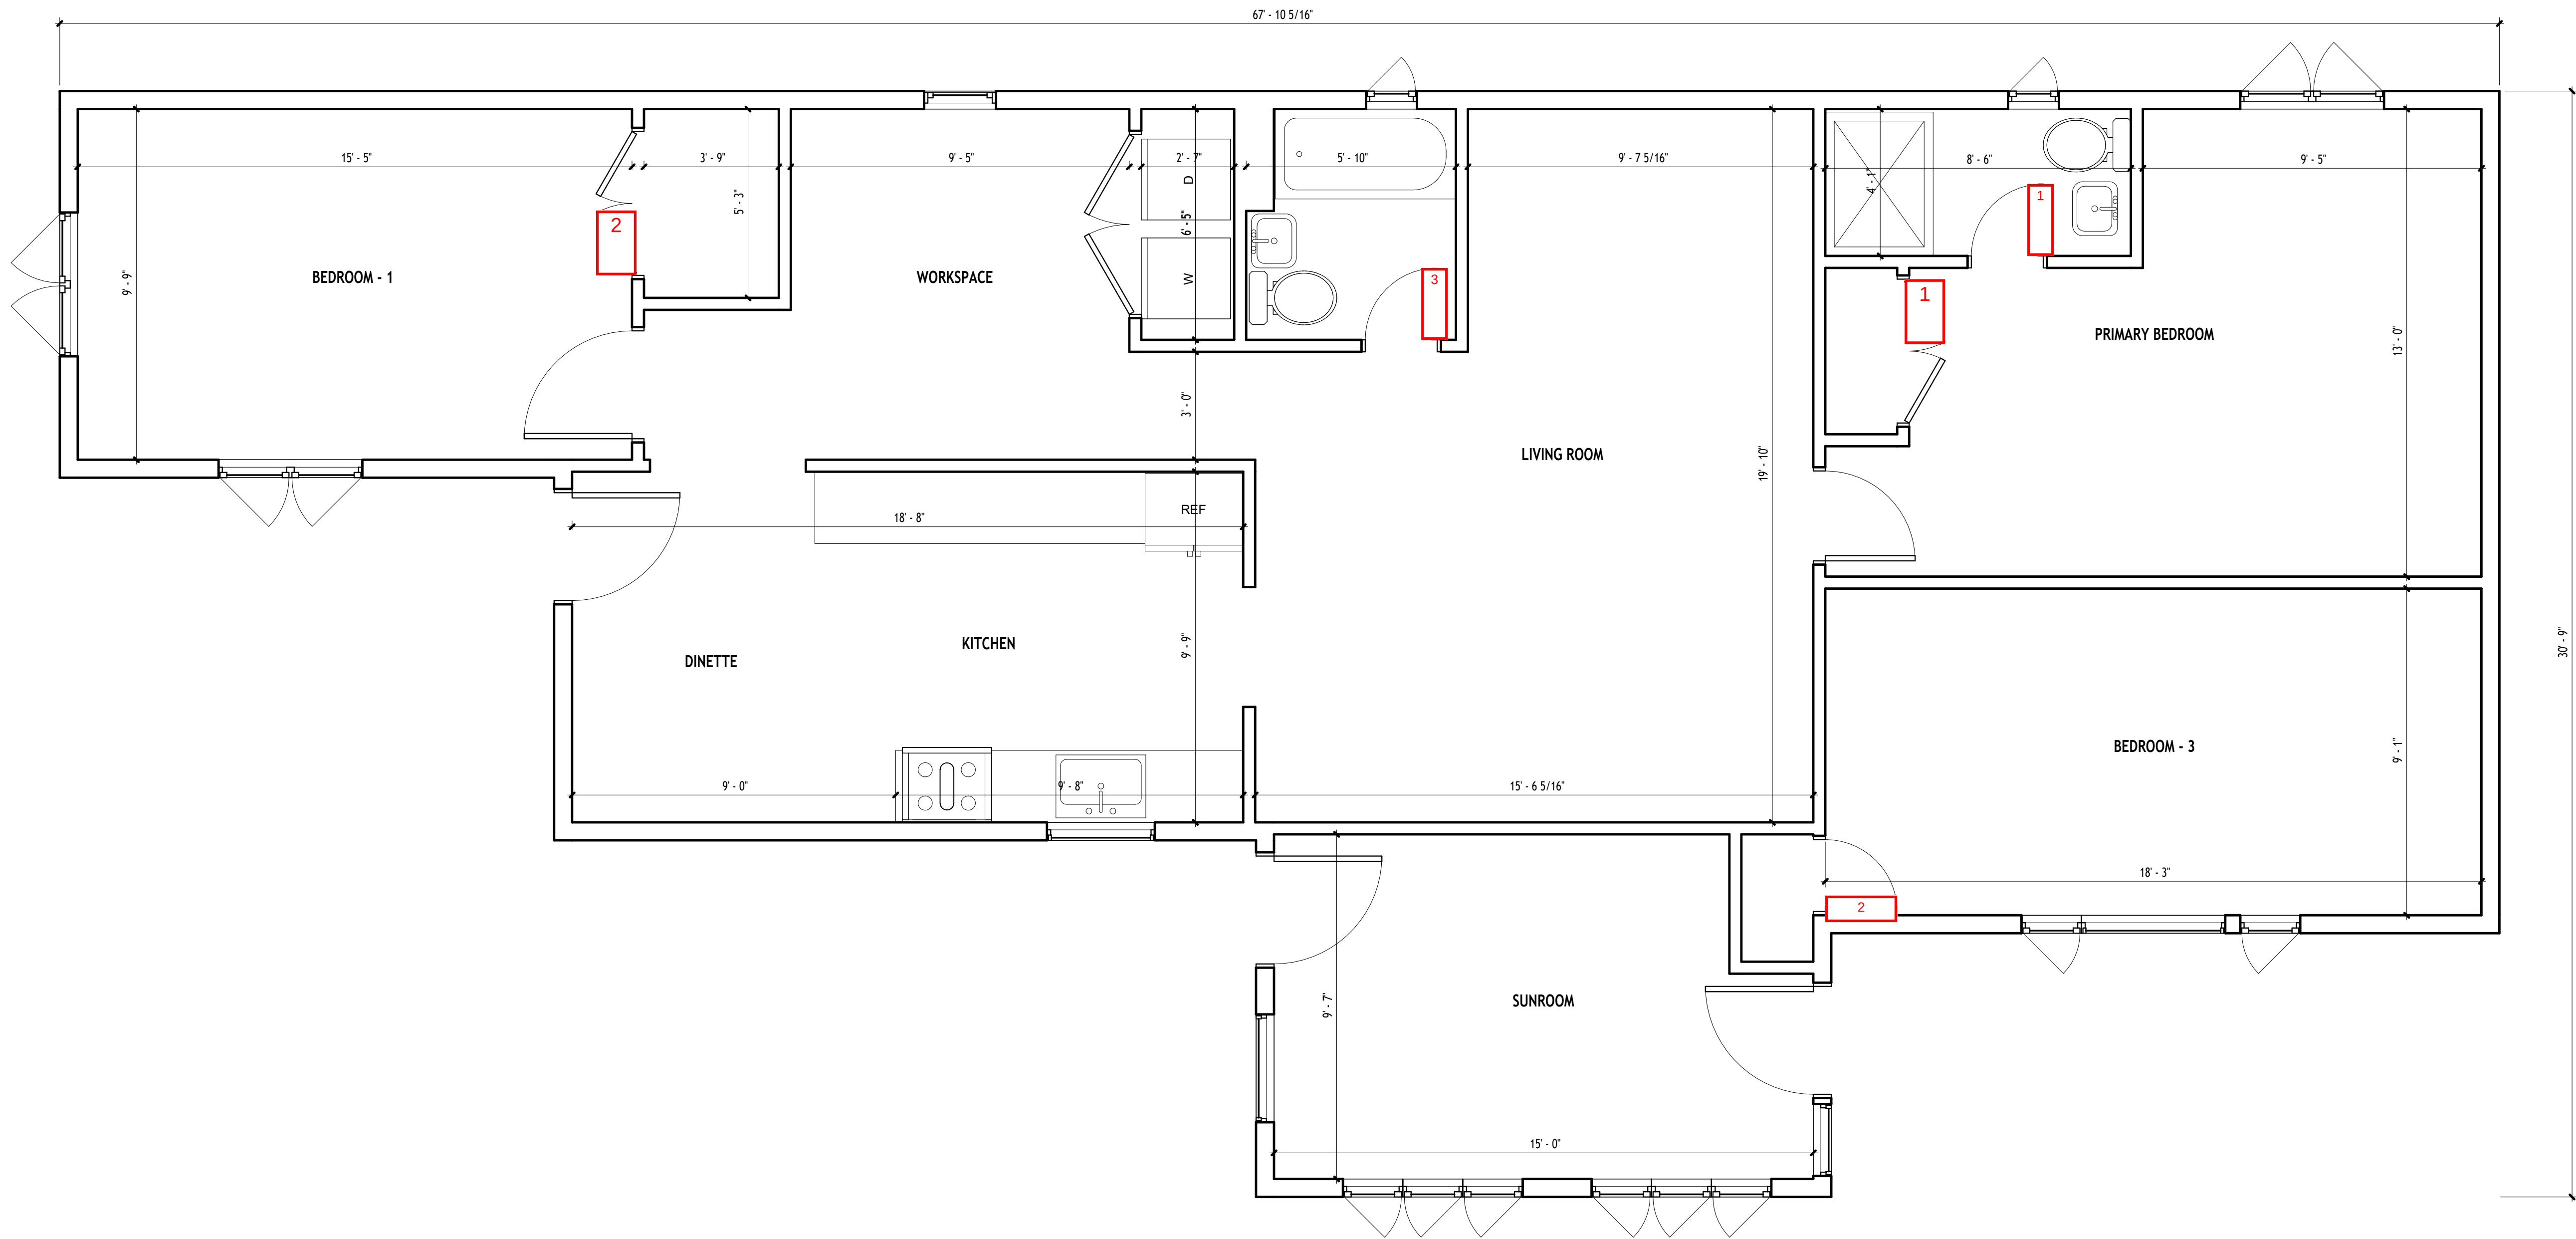

① AS BUILT FLOOR PLAN

3/8" = 1'-0"