



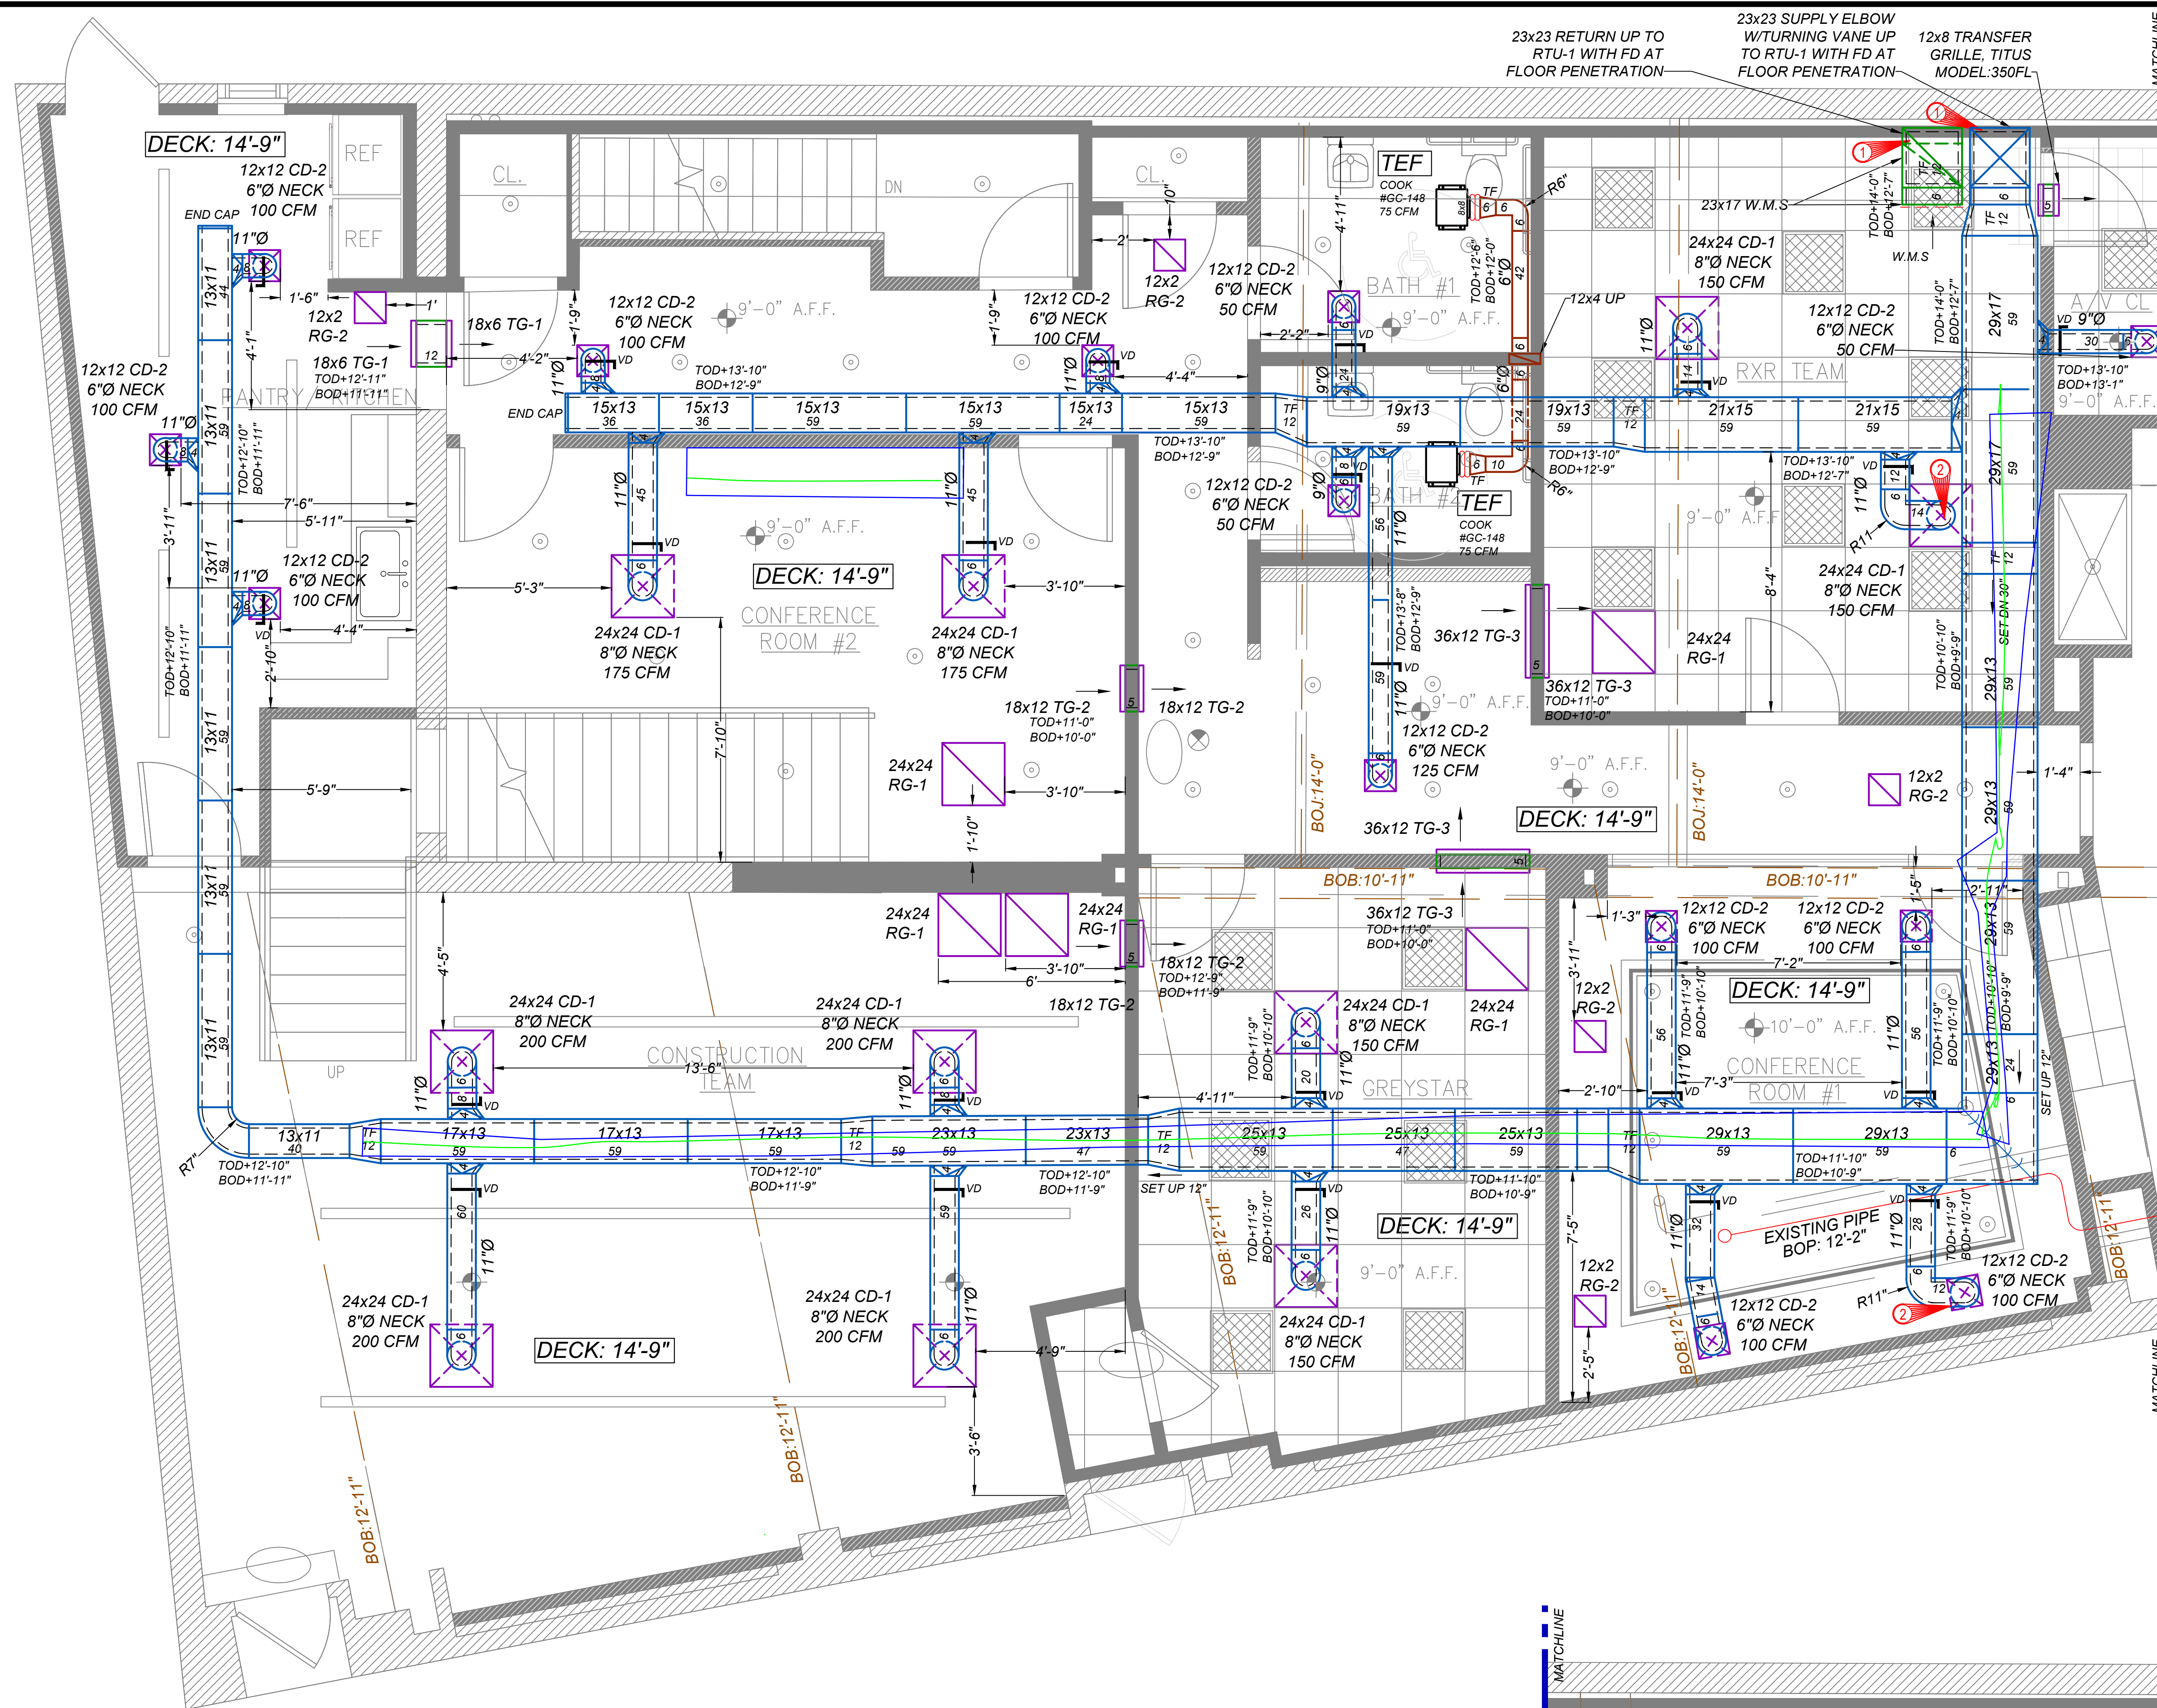

HVAC FIRST FLOOR SHOP DRAWING (1 OF 2)
SCALE: 3/8" = 1'-0"

- NOTES:
1. ALL CEILING DIFFUSER SHALL BE PROVIDED WITH VERTICAL FLEX CONNECTION. SEE PLAN FOR SIZE.
 2. ALL SUPPLY AND RETURN DUCT WORK SHALL BE PROVIDED WITH 1.5" THICK LINING.
 3. ALL TRANSFER GRILLES TO BE INSTALLED ABOVE SUSPENDED CEILING.

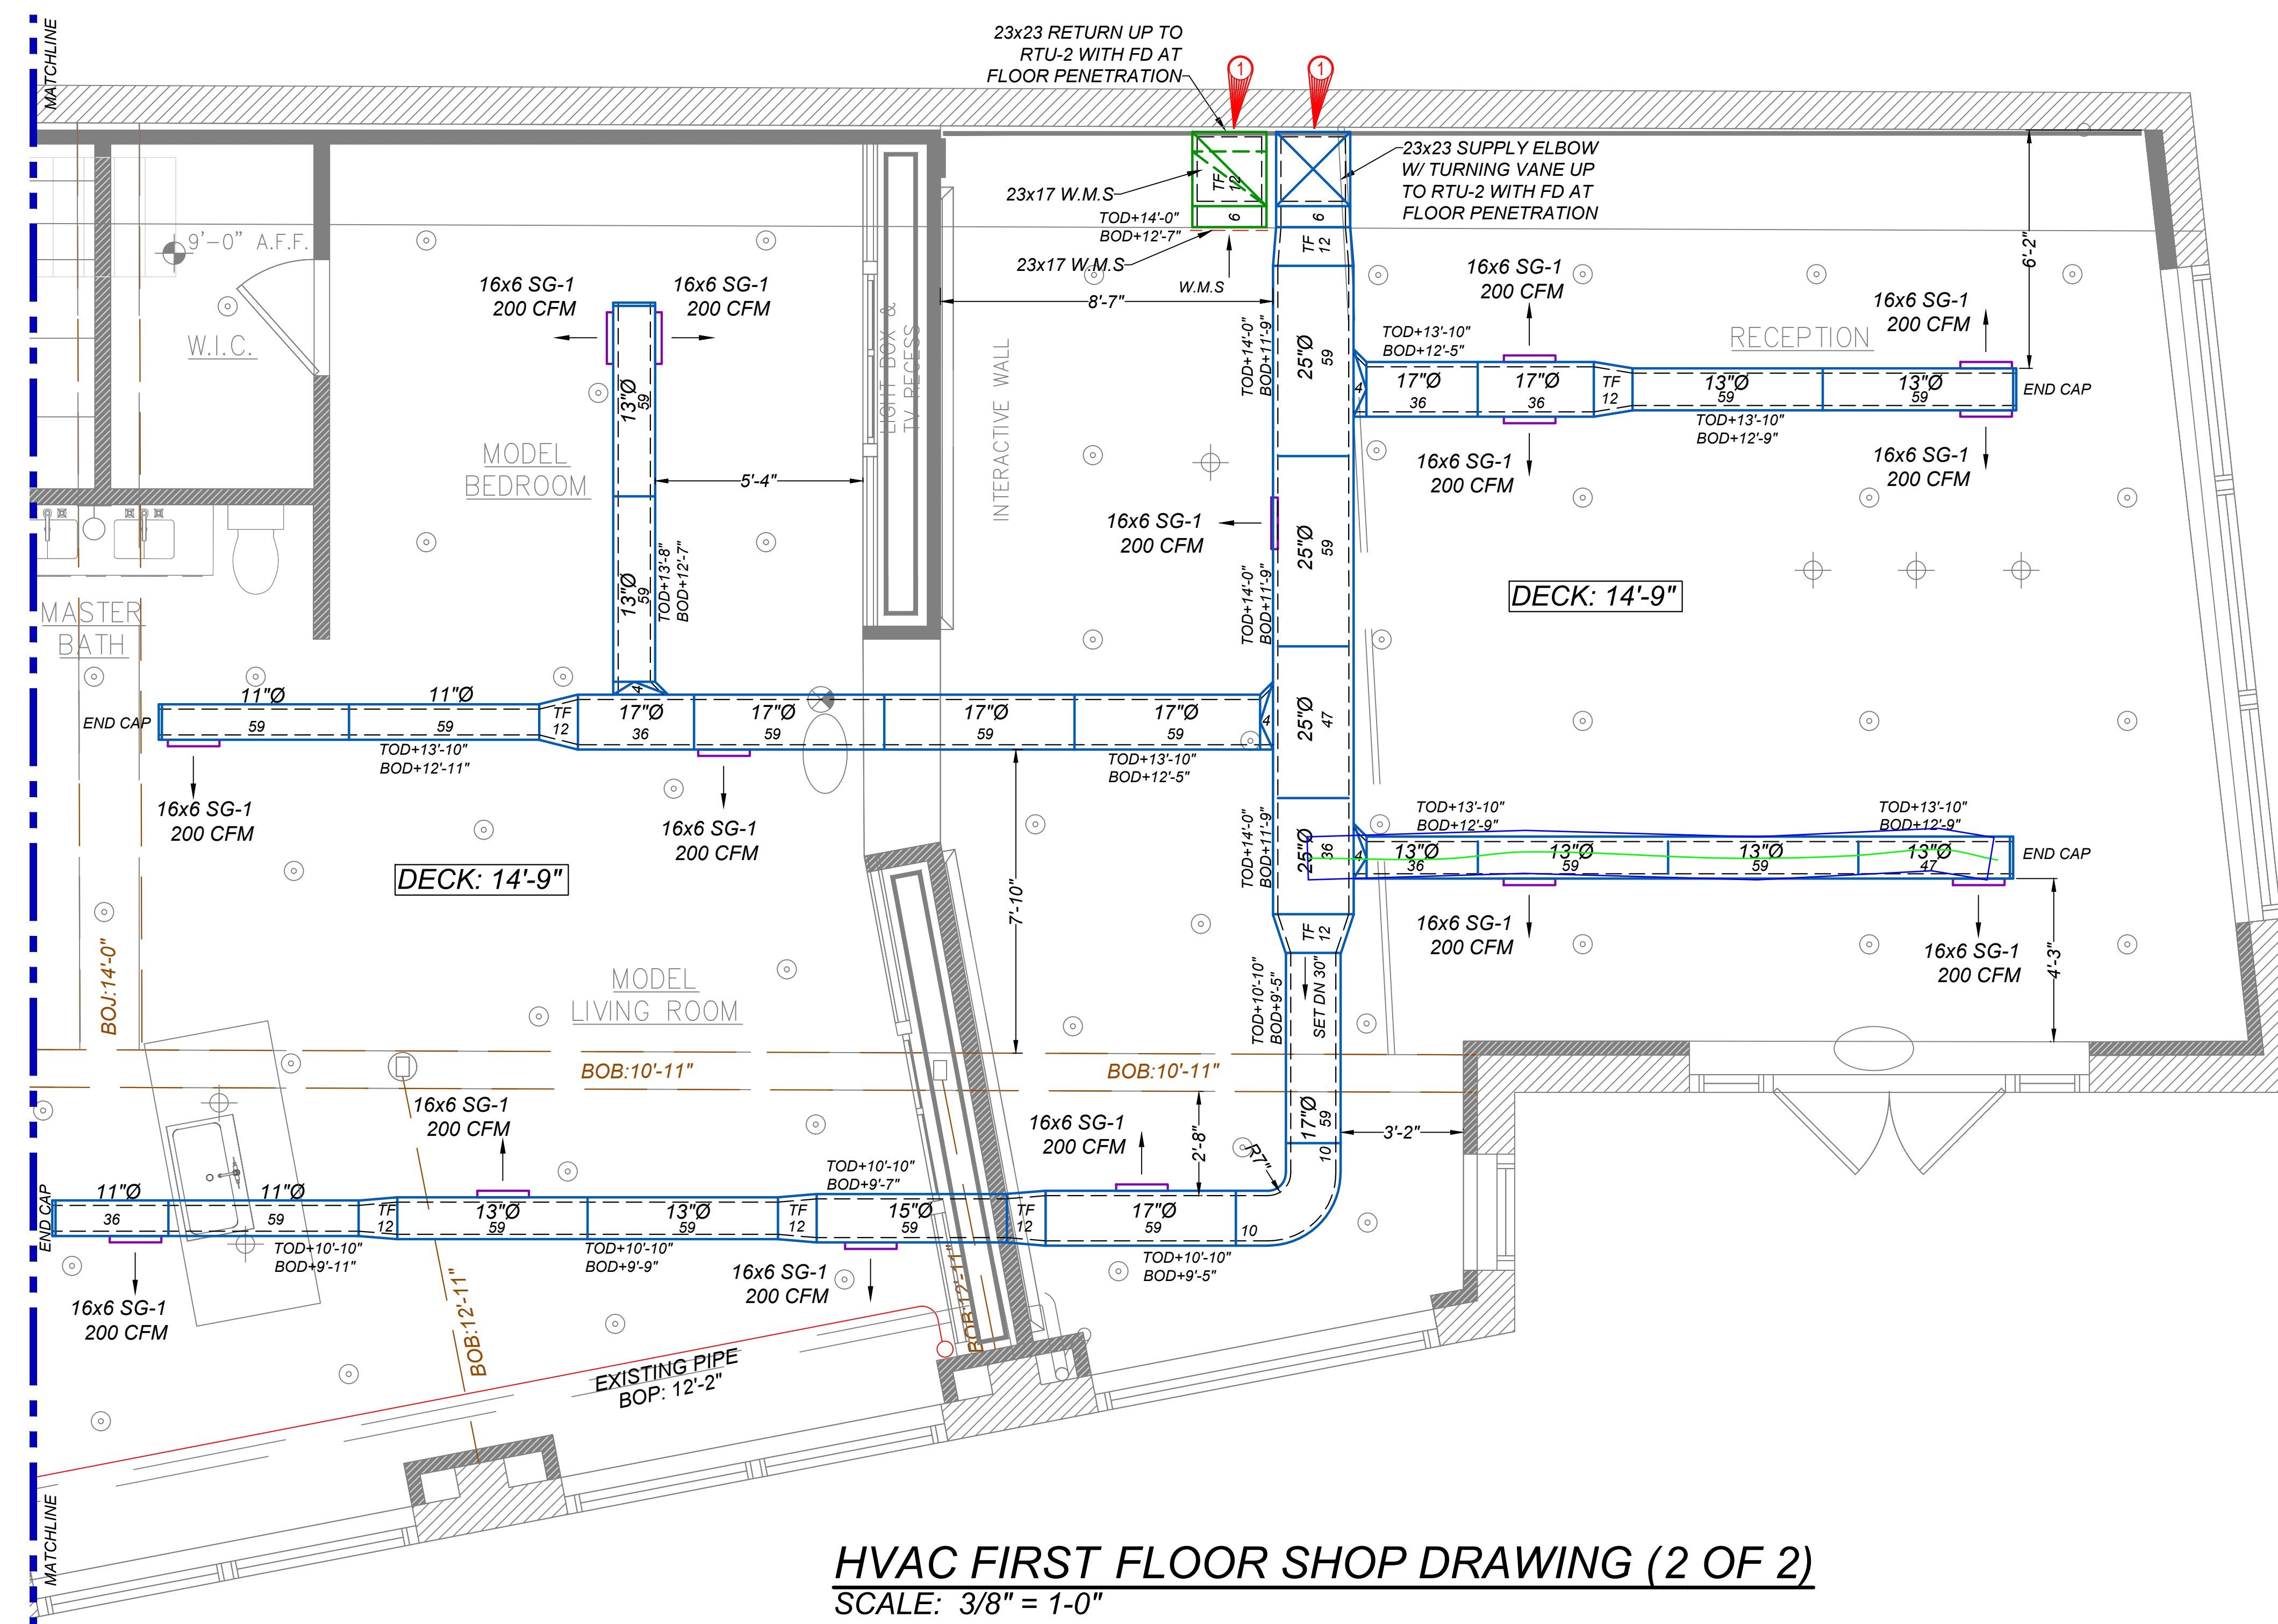

HVAC FIRST FLOOR SHOP DRAWING (2 OF 2)
SCALE: 3/8" = 1'-0"

FLAG NOTES

1. CONFLICTING WITH WALL. ENGINEER TO VERIFY.
2. CONFLICTING WITH SPRINKLER HEAD. ENGINEER TO VERIFY.

03	04/10/2020	UPDATE AS PER MARKUPS
02	03/27/2020	REVISE AS PER MARKUPS
01	03/16/2020	FOR APPROVAL

NO. DATE: DESCRIPTION:

MECHANICAL CONTRACTOR:
LRC CONSTRUCTION, LLC.
7 RENAISSANCE SQUARE, 4TH
FLOOR WHITE PLAINS,
NY 10601
PHONE: 914-773-7700
FAX: 914-946-1670

DRAWING NAME:
**HVAC FIRST FLOOR SHOP
DRAWING**

PROJECT INFORMATION:
**RXR WELCOME
CENTER**
507 Rochelle Street
New Rochelle, NY 10801

Drawn By: SB Chkd By: MH
Scale: 3/8"=1'-0" Date: 03/16/20 Drawing Number:
PAGE-36x48 M-101

