



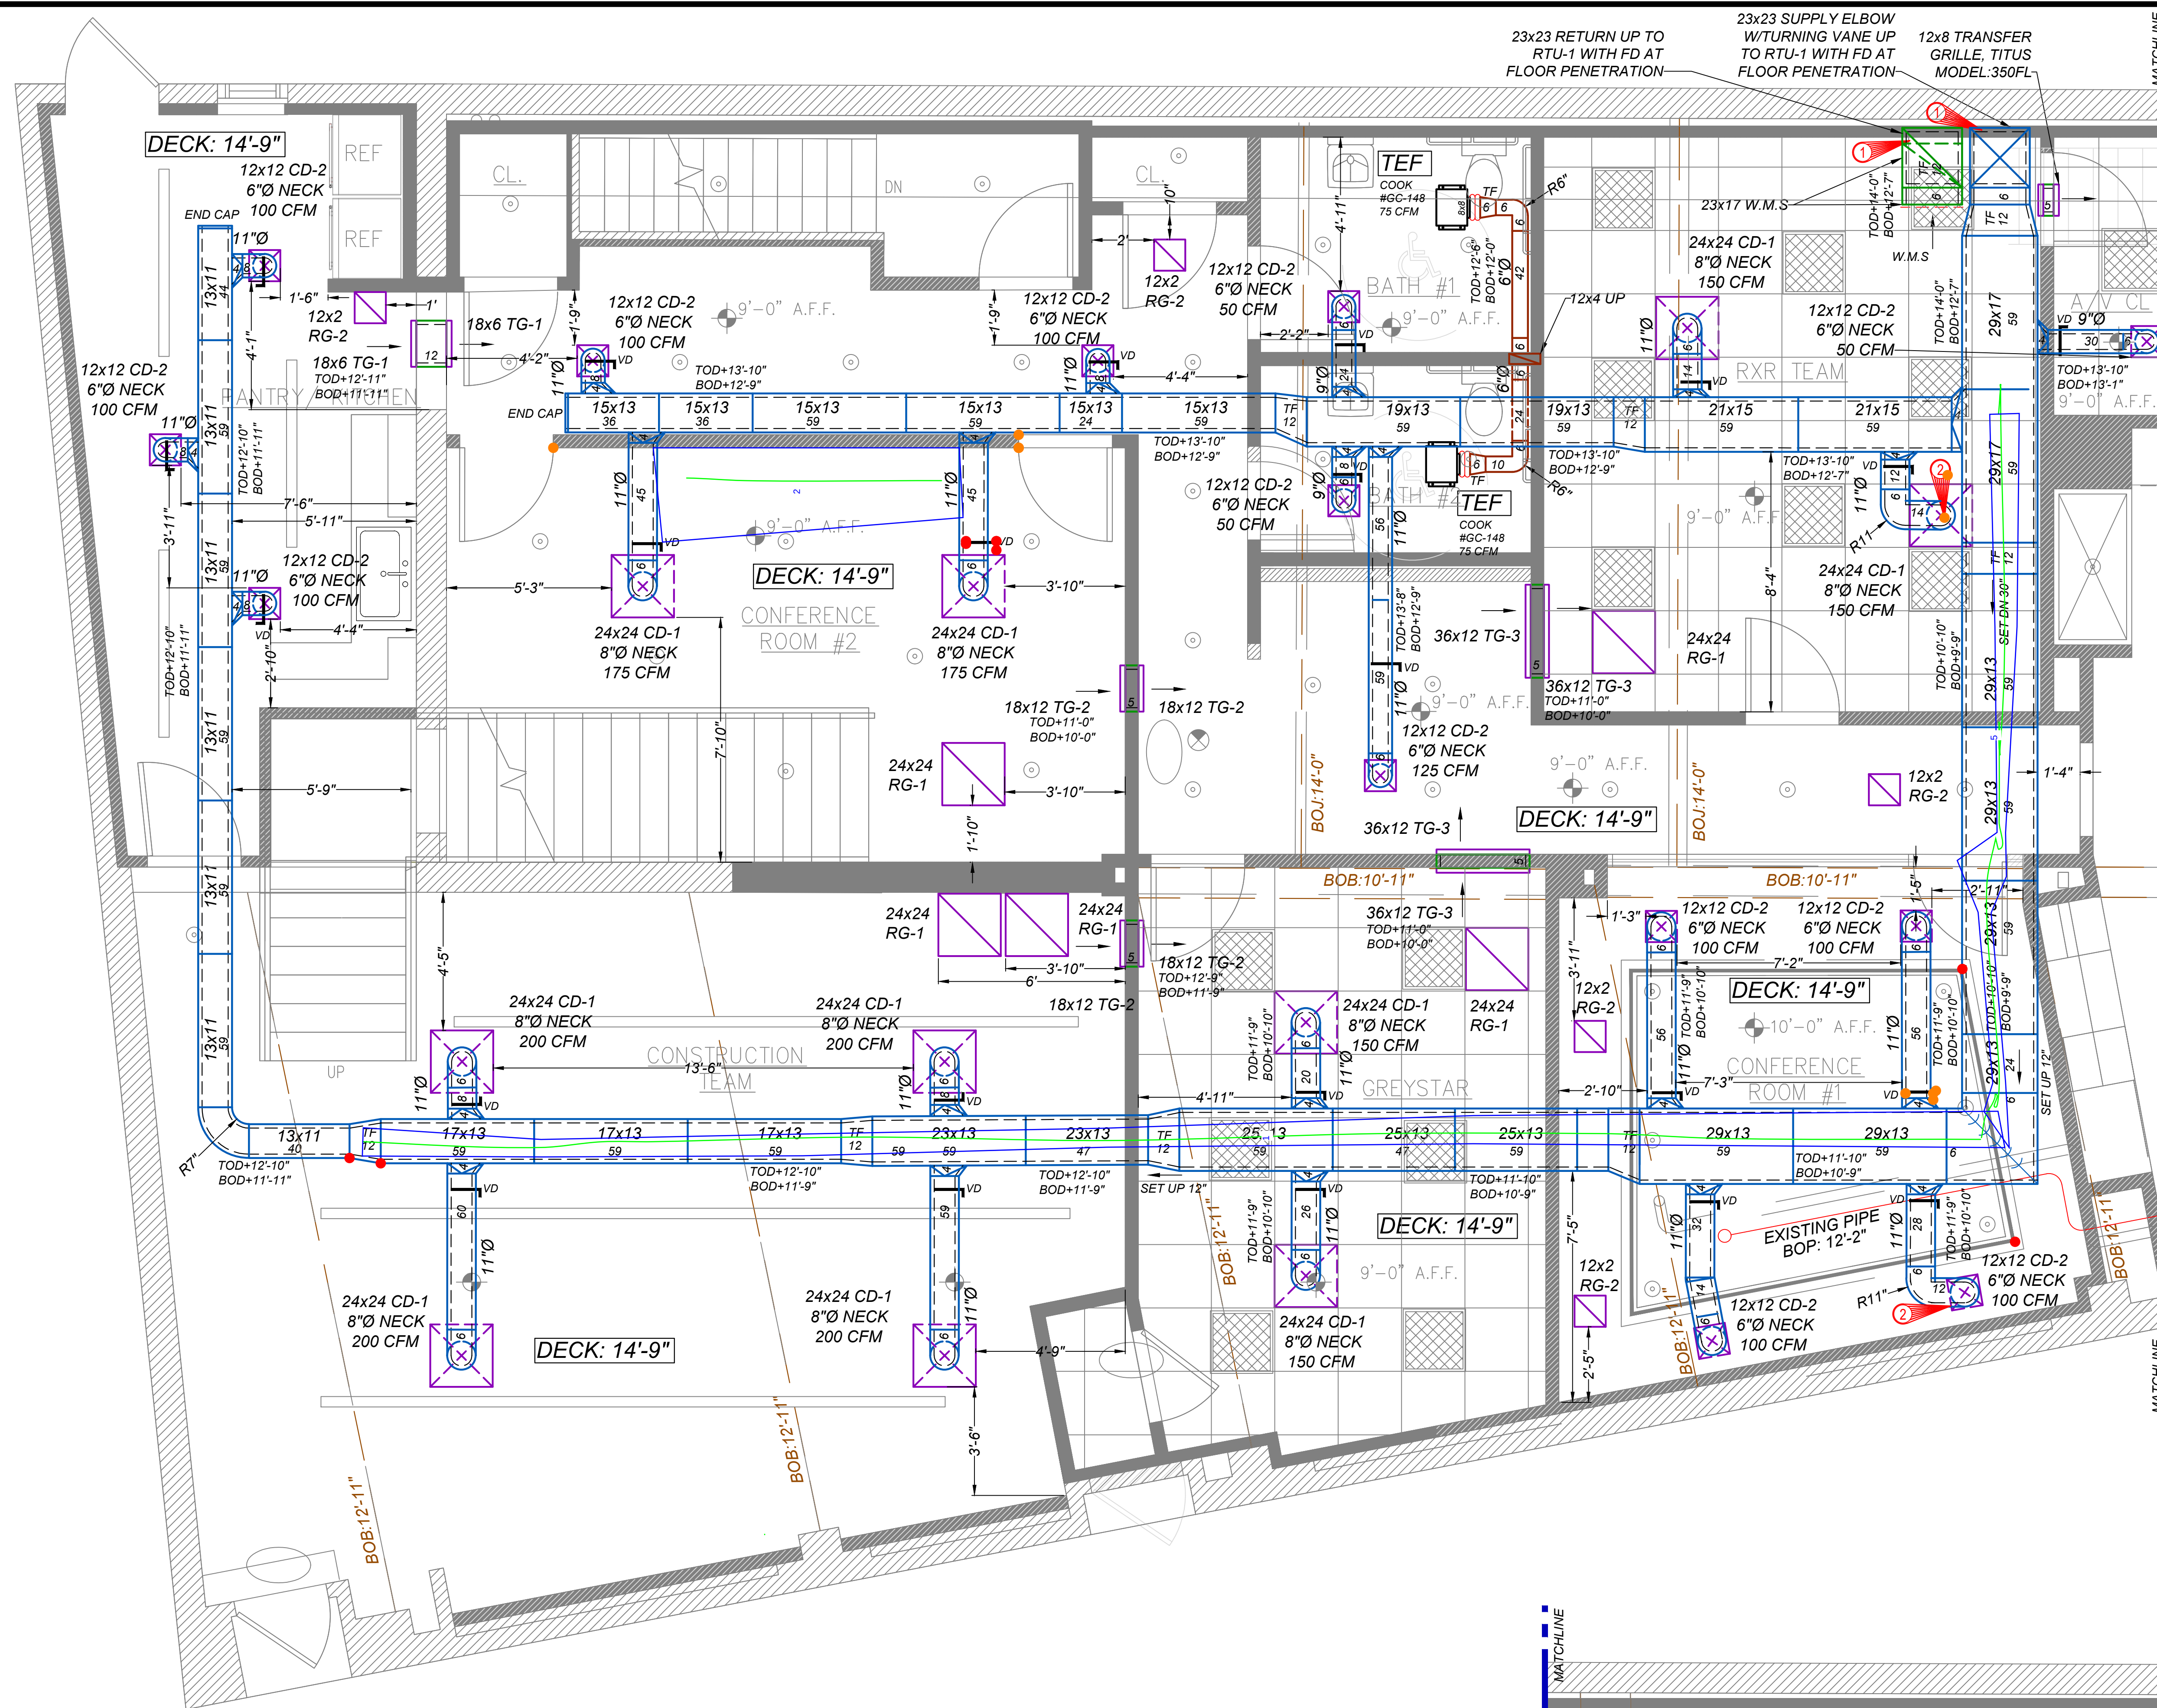

HVAC FIRST FLOOR SHOP DRAWING (1 OF 2)
SCALE: 3/8" = 1'-0"

- NOTES:
1. ALL CEILING DIFFUSER SHALL BE PROVIDED WITH VERTICAL FLEX CONNECTION. SEE PLAN FOR SIZE.
 2. ALL SUPPLY AND RETURN DUCT WORK SHALL BE PROVIDED WITH 1.5" THICK LINING.
 3. ALL TRANSFER GRILLES TO BE INSTALLED ABOVE SUSPENDED CEILING.

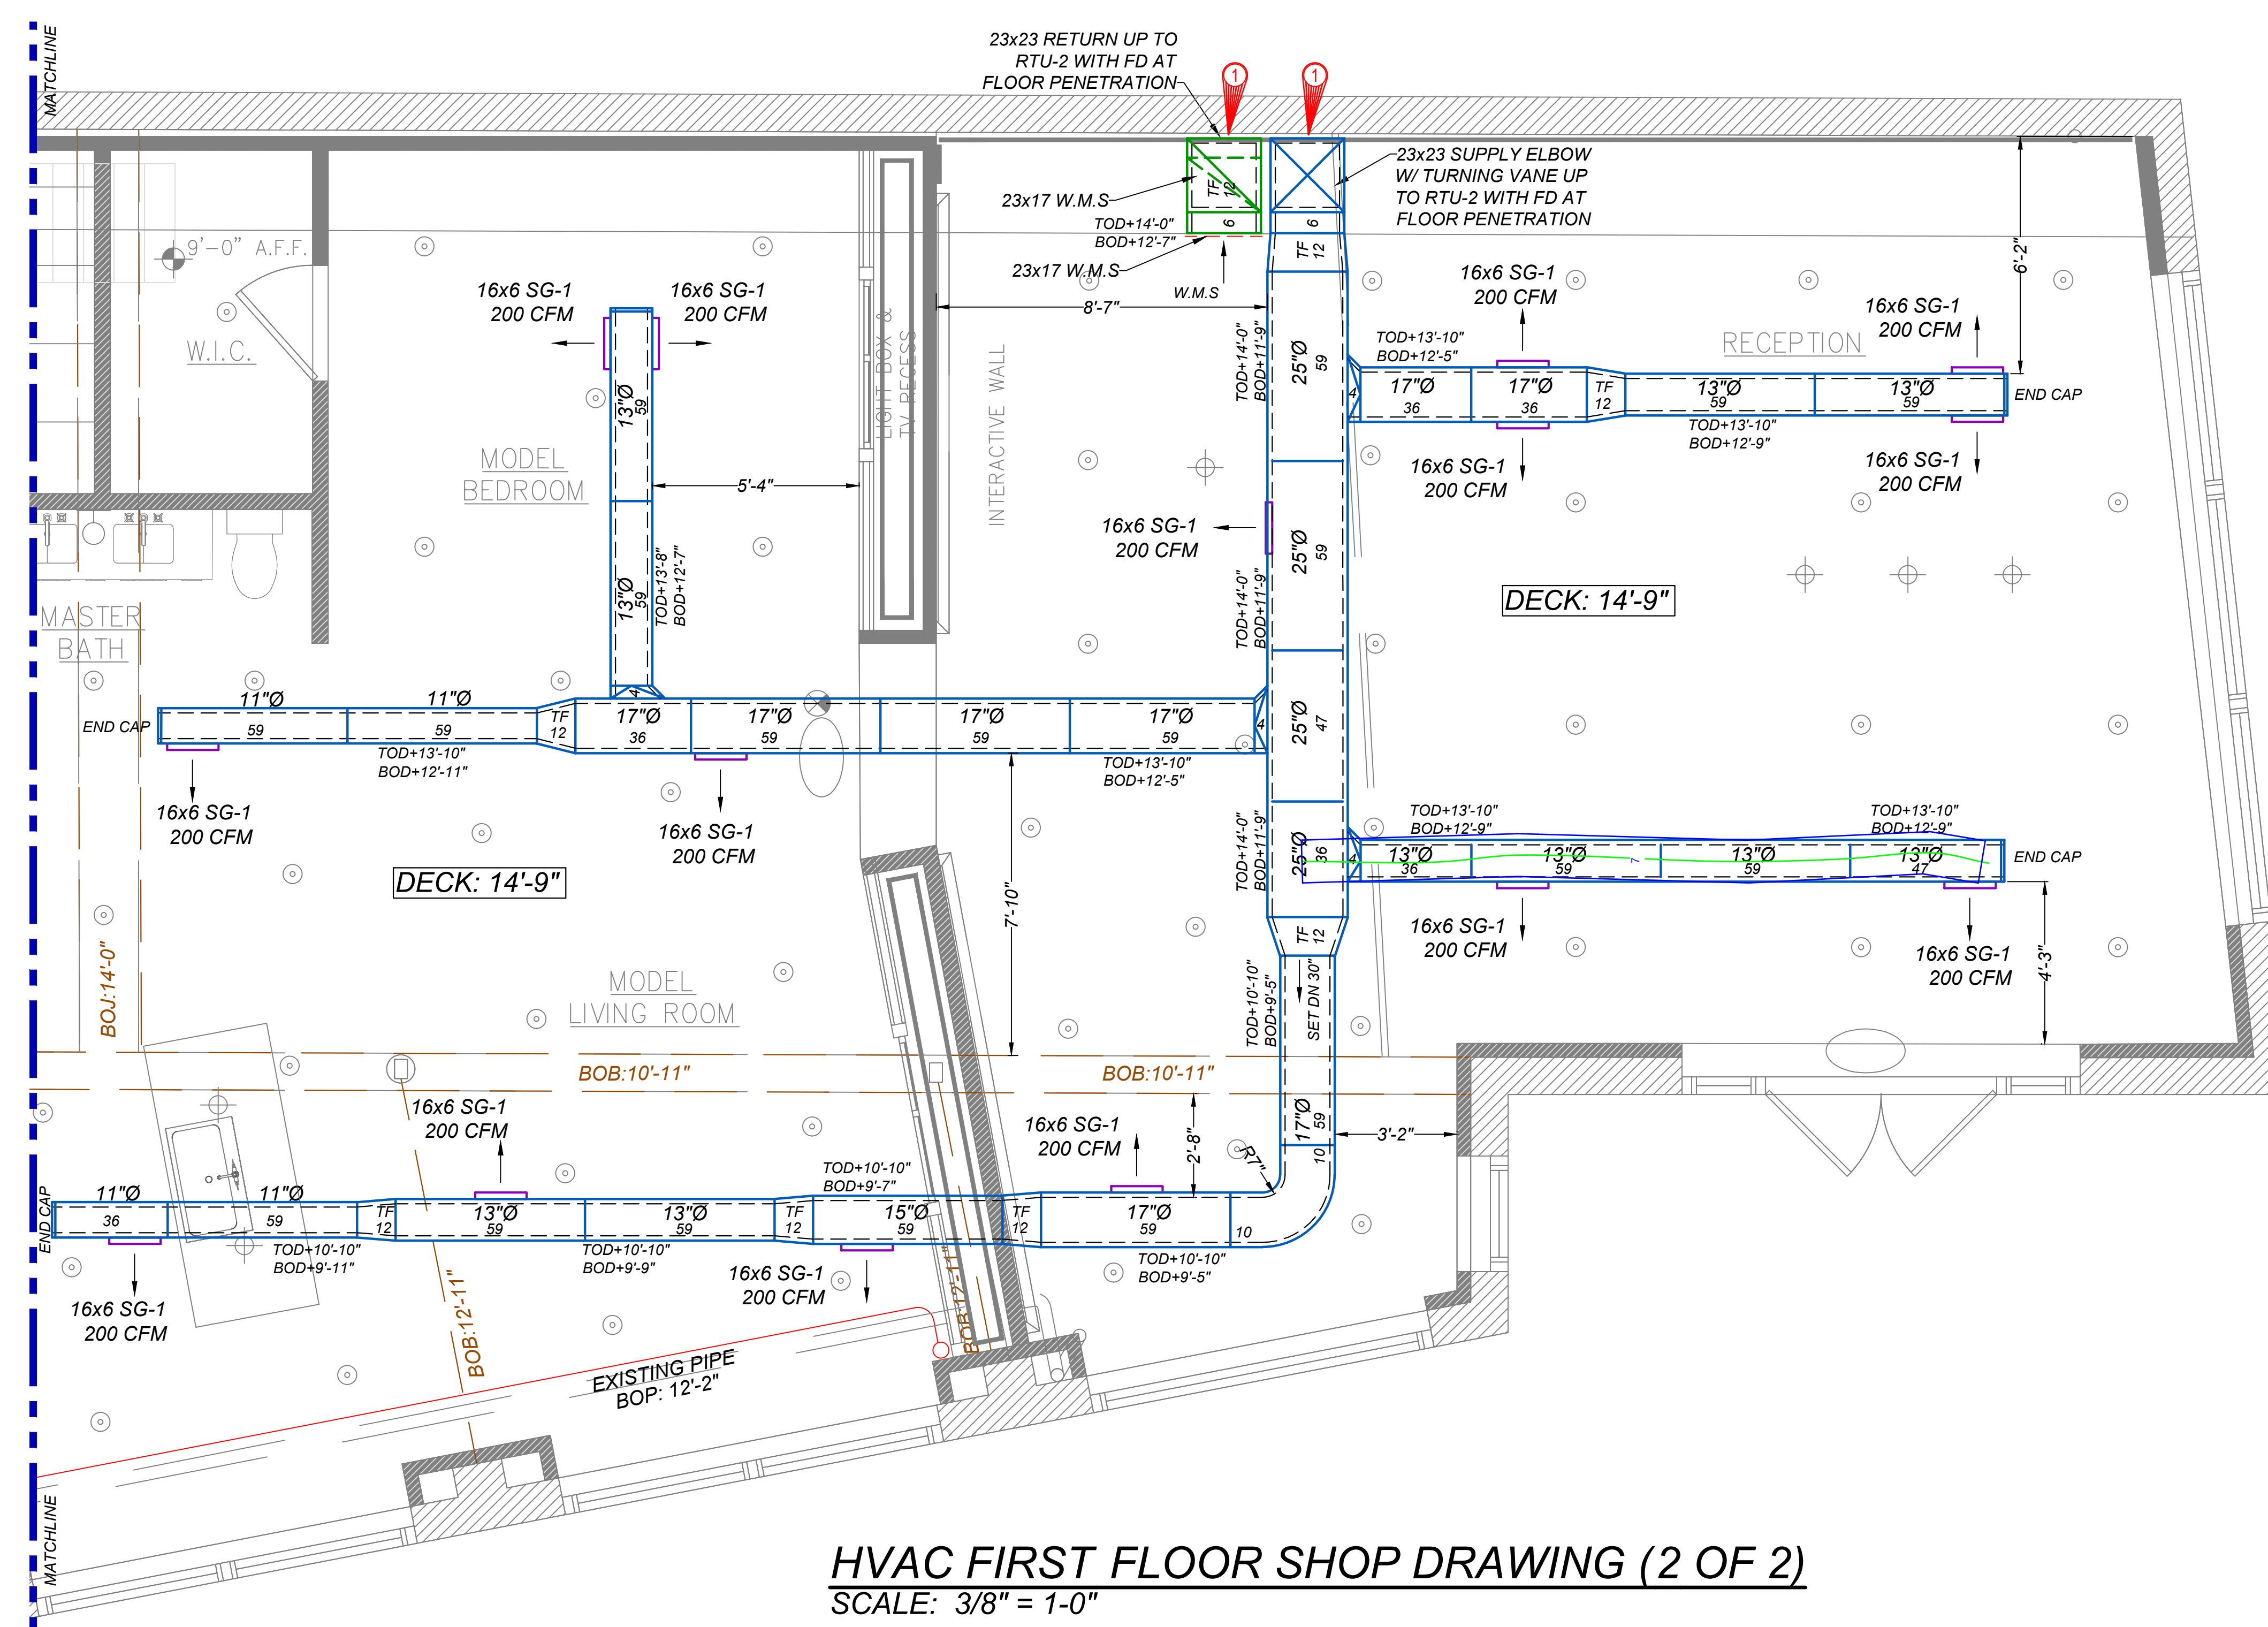

HVAC FIRST FLOOR SHOP DRAWING (2 OF 2)
SCALE: 3/8" = 1'-0"

FLAG NOTES

1. CONFLICTING WITH WALL. ENGINEER TO VERIFY.
2. CONFLICTING WITH SPRINKLER HEAD. ENGINEER TO VERIFY.

03	04/10/2020	UPDATE AS PER MARKUPS
02	03/27/2020	REVISE AS PER MARKUPS
01	03/16/2020	FOR APPROVAL
NO.	DATE:	DESCRIPTION:
REVISIONS		
MECHANICAL CONTRACTOR:		
LRC CONSTRUCTION, LLC.		
7 RENAISSANCE SQUARE, 4TH FLOOR WHITE PLAINS, NY 10601		
PHONE: 914-773-7700 FAX: 914-946-1670		
DRAWING NAME:		
HVAC FIRST FLOOR SHOP DRAWING		
PROJECT INFORMATION:		
RXR WELCOME CENTER		
507 Rochelle Street		
New Rochelle, NY 10801		
Drawn By: SB	Chkd By: MH	
Scale: 3/8"=1'-0"	Date: 03/16/20	Drawing Number
PAGE-36x48	M-101	

